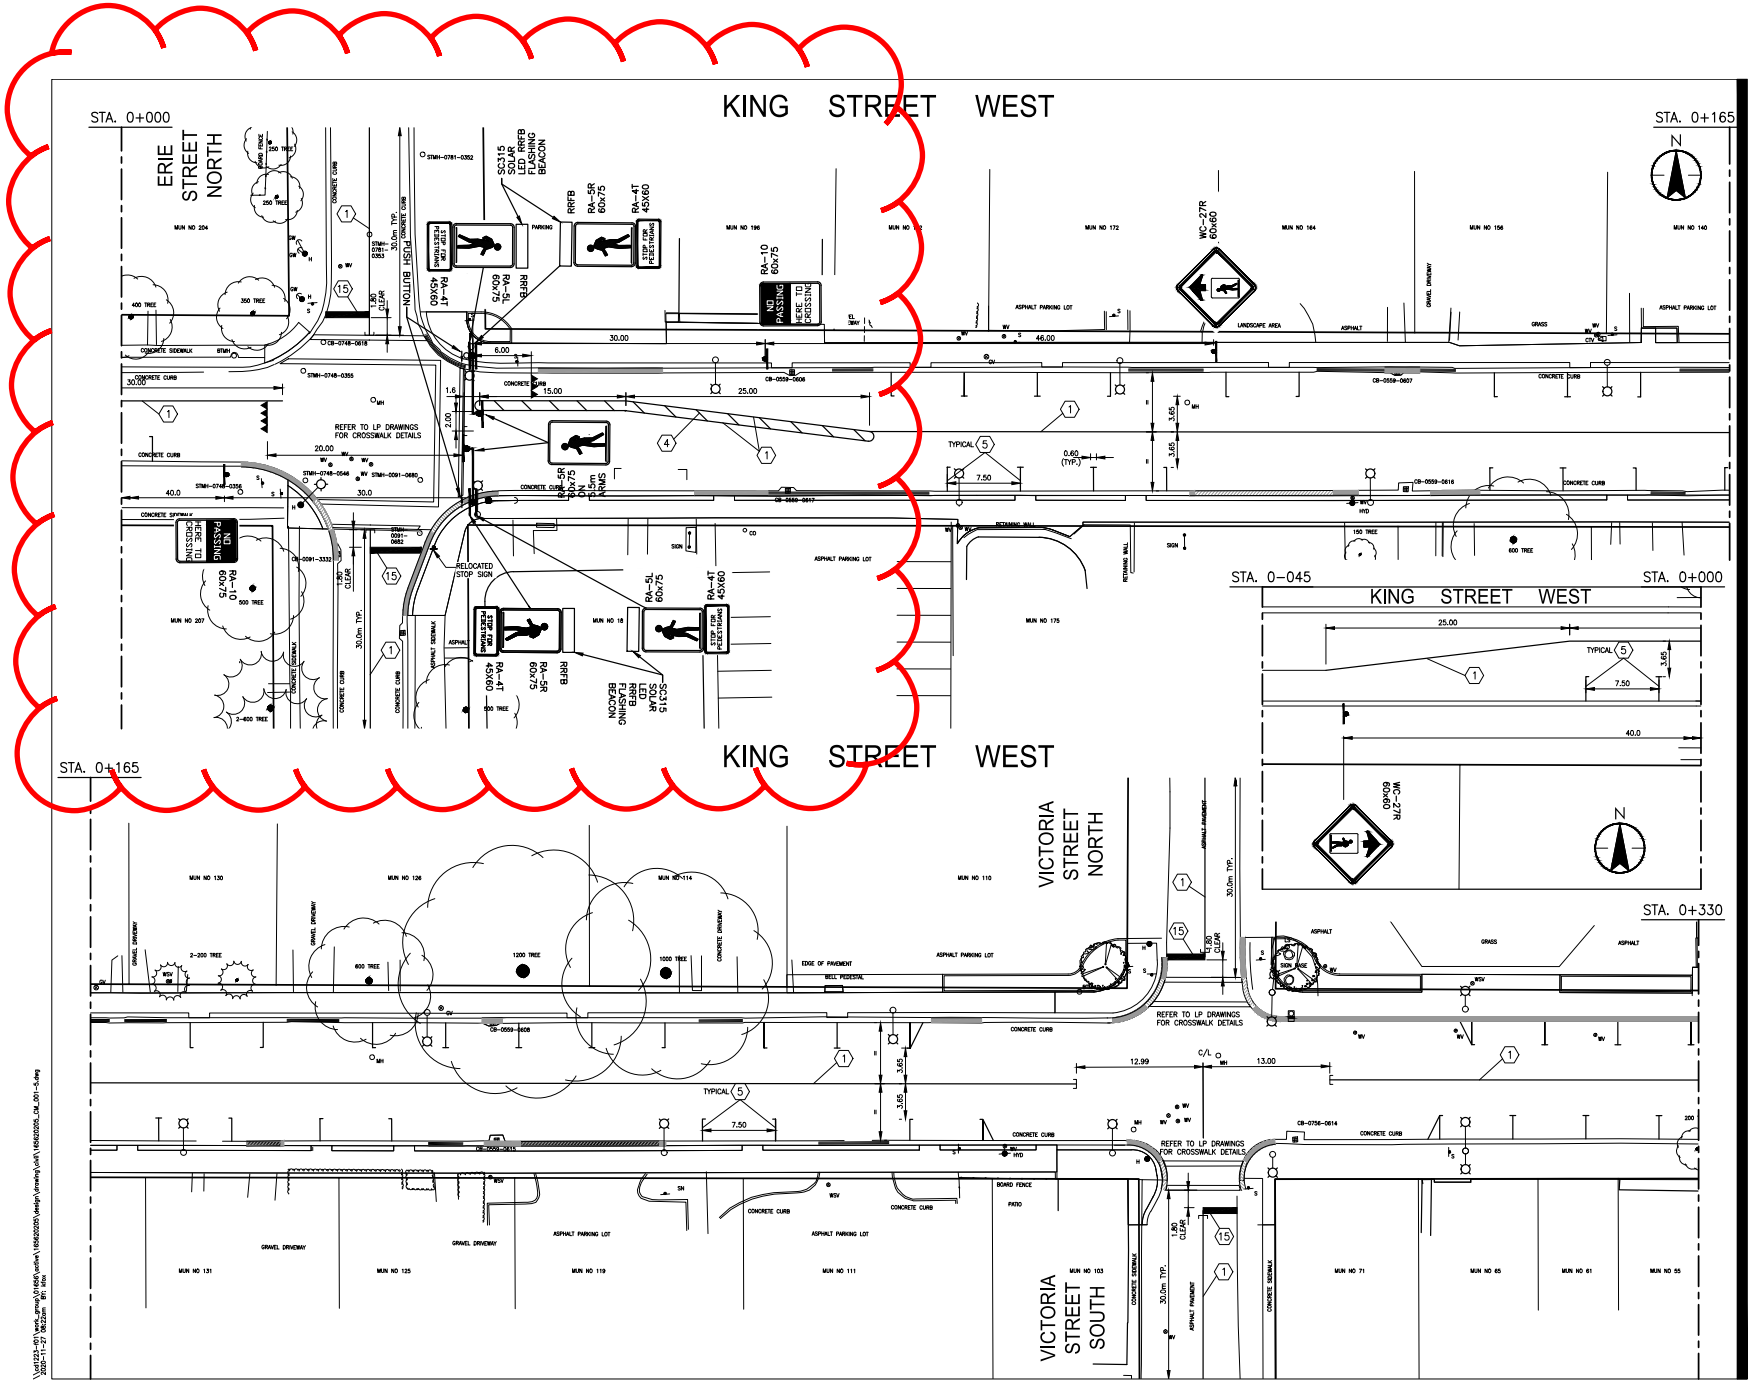

Stantec

Stantec
140 Ouellette Place Suite 100
Windsor ON Canada N8X 1L9
Tel: 519.966.2250
www.stantec.com

Copyright Reserved

The Contractor shall verify and be responsible for all dimensions. DO NOT scale the drawing - any errors or omissions shall be reported to Stantec without delay.
The Copyrights to all designs and drawings are the property of Stantec. Reproduction or use for any purpose other than that authorized by Stantec is forbidden.

Legend

1	SOLID YELLOW,10cm
2	SOLID DOUBLE YELLOW,10cm
3	363 BROKEN YELLOW,10cm
4	SOLID YELLOW,20cm
5	SOLID WHITE,10cm
6	333 BROKEN WHITE,10cm
7	363 BROKEN WHITE,10cm
8	393 BROKEN WHITE,10cm
9	SOLID WHITE,20cm
10	111 BROKEN WHITE,10cm
11	333 BROKEN WHITE,20cm
12	333 BROKEN WHITE,30cm
13	SOLID WHITE,30cm
14	SOLID WHITE,45cm
15	SOLID WHITE,60cm
20	SYMBOLS
[ ]	LIMITS OF MARKINGS

NOTES:
1. 333, 363, 393, Denotes Pavement Marking Spacing (ie., 3 m line, 3 m gap, 3 m line)
2. Use (1) to Denote PAVEMENT MARKING
3. Use [1] to Denote PAVEMENT MARKING, TEMPORARY
4. Use △1 to Denote PAVEMENT MARKING, TEMPORARY-REMOVABLE
5. Use (1) to Denote PAVEMENT MARKING, DURABLE

Notes

1. PAVEMENT MARKING TO BE FIELD ADJUSTED AS REQUIRED TO SUIT AS CONSTRUCTED CONDITIONS.
2. PAVEMENT MARKING TO CONFORM TO ONTARIO TRAFFIC MANUAL BOOK II.

Revision	By	Appd.	YY.MM.DD
D TENDER	C.R.G.J.	C.R.G.J.	2020.11.25
C OWNER REVIEW	C.R.G.J.	C.R.G.J.	2020.10.23
B TOWN REVIEW	C.R.G.J.	C.R.G.J.	2020.07.15
A INITIAL TOWN REVIEW	C.R.G.J.	C.R.G.J.	2020.06.19

Issued	By		Appd.	YY.MM.DD
File Name: 165620205_CM_001-5	K.F.F. Dwn.	C.R.G.J. Chkd.	C.R.G.J. Dsgn.	2020.04.22

Permit/Seal

LICENSED PROFESSIONAL ENGINEER
2020.11.25
C.R.G. JUBENVILLE
PROVINCE OF ONTARIO

Client/Project
TOWN OF ESSEX

DOWNTOWN HARROW
STREETSCAPE IMPROVEMENTS

Town of Essex, Ontario

Title
PAINTING
KING STREET
STA. 0+000 TO STA. 0+330

Project No.
165620205

Scale
1:250 2.5 7.5 12.5m

Revision

Drawing No.
CM-001

\\cd1223-f01\work_group\01650\active\165620205\design\drawing\cad\165620205_CM_001-5.dwg
2020-11-27 08:22am BY: kfox